



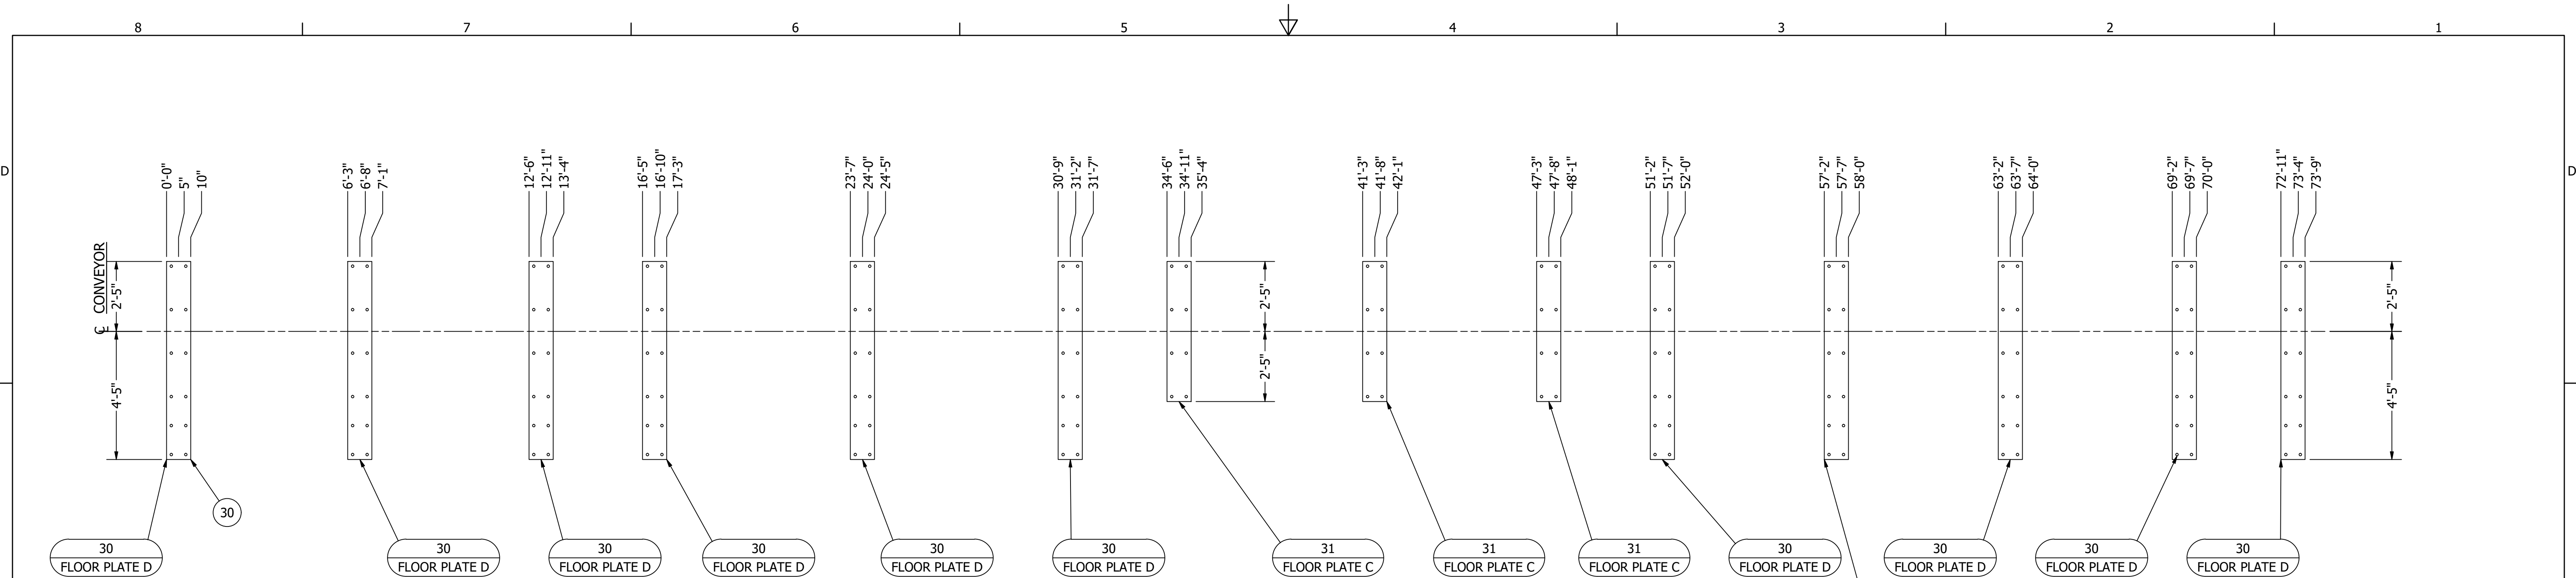

SETTING PLAN
SCALE 1 / 32

SHIPPING TABLE	
ITEM	WEIGHT
SHIPPING SEC A	11,300 LBS
SHIPPING SEC B	8,500 LBS
SHIPPING SEC C	9,400 LBS
SHIPPING SEC D	9,200 LBS
HIGH SIDE 1	1,600 LBS
HIGH SIDE 2 A	800 LBS
HIGH SIDE 2 B	800 LBS
FLOOR PLATES	2,400 LBS
MOTOR	500 LBS
TOTAL	44,500 LBS

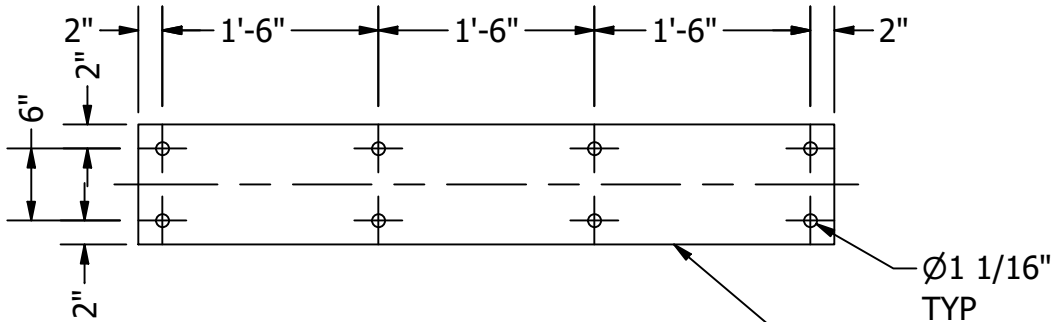

FLOOR PLATE DETAIL C
SCALE 3/4"=1'-0"


1
FLOOR PLATE C

ANCHOR PLATE NOTES

- EPOXY FLOOR PLATES TO FLOOR WITH: CONCESSIVE PASTE (LPL) SUITABLE ABOVE 60° F. OR (SPL) WHICH MAY BE USED IN A TEMPERATURE RANGE OF 35 TO 60° F. PER MANUFACTURER'S RECOMMENDATIONS (BY OTHERS).


CONTACT: BASF BUILDING SYSTEMS
889 VALLEY PARK DR
SHAKOPEE, MN 55379
(800) 433-9517
WWW.CHEMREX.COM

- USE NON-LEAD TYPE ANCHOR BOLTS SUITED FOR FATIGUE APPLICATIONS (BY OTHERS)

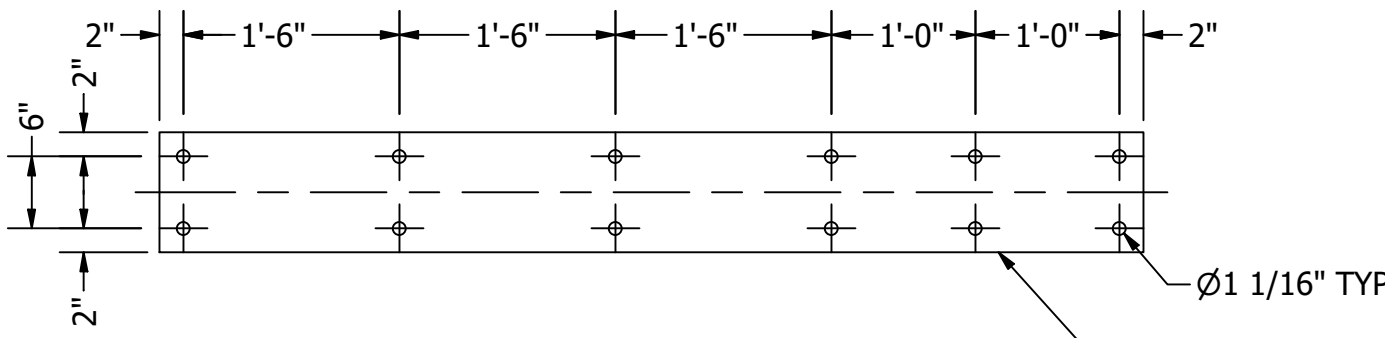


FLOOR PLATE DETAIL D
SCALE 3/4"=1'-0"


1
FLOOR PLATE D

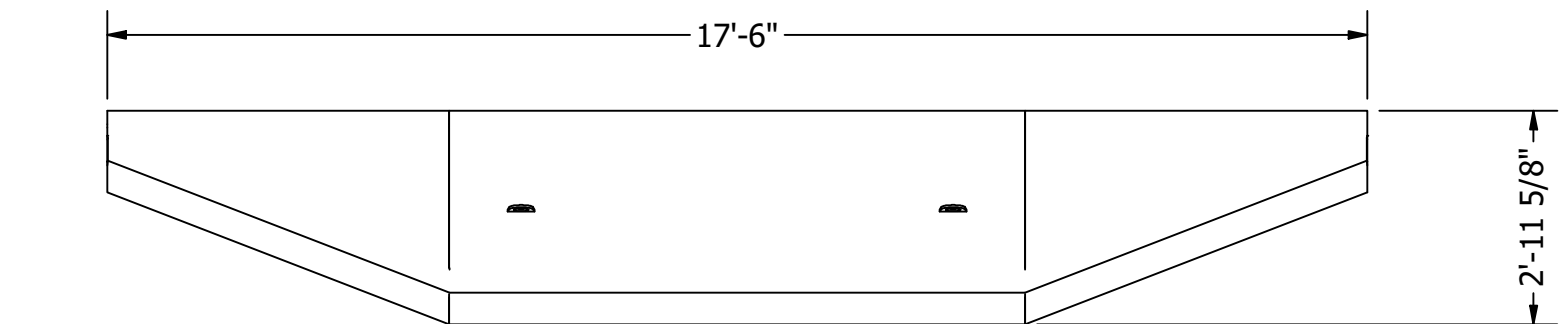



HIGH SIDE 1 SHIPPING VIEW
SCALE 1 / 32

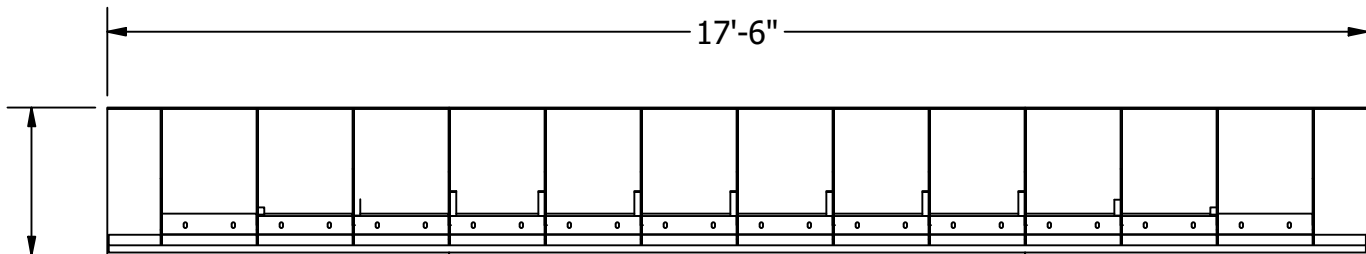

HIGH SIDE 2 A SHIPPING VIEW
SCALE 1 / 32

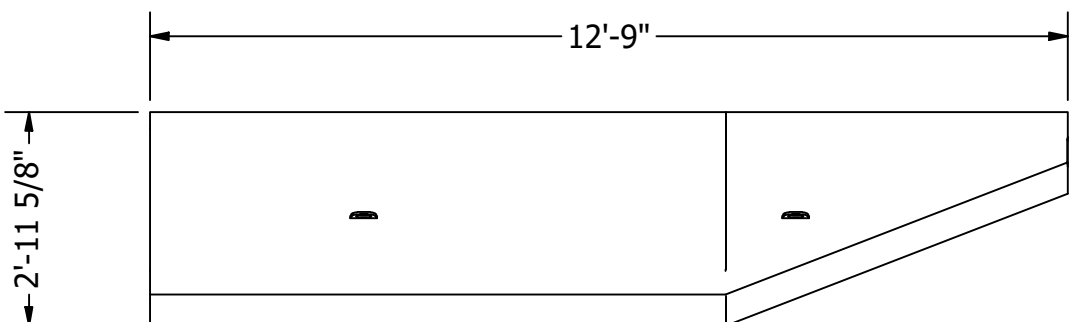

HIGH SIDE 2 B SHIPPING VIEW
SCALE 1 / 32

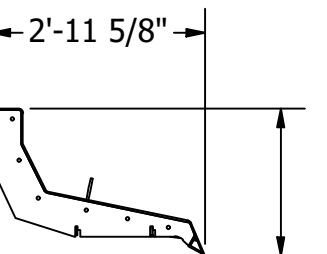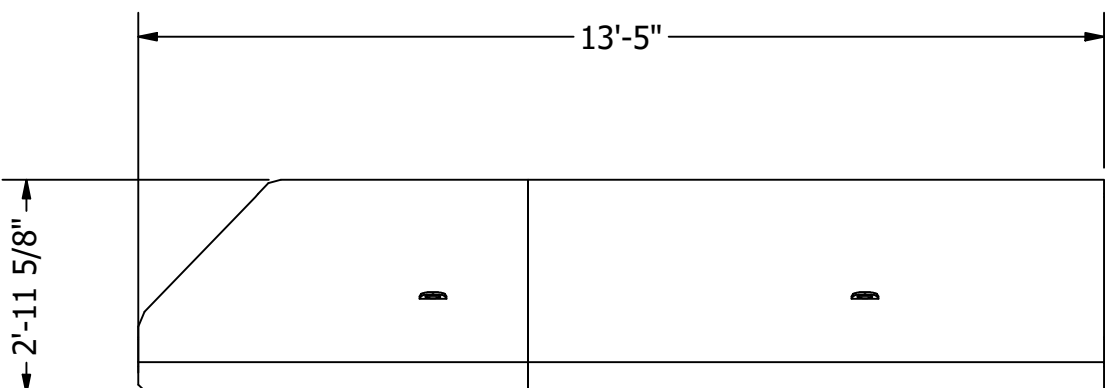

WM# SLPT-017-60-030

STATIC LOAD		DYNAMIC LOADING		MODEL / SIZE		OPERATING SPECIFICATIONS		NOTES		THIS DRAWING WITH THE DESIGNS, IDEAS, AND DETAILS SHOWN HEREON IS THE PROPERTY OF ACTION EQUIPMENT COMPANY, INC., NEWBERG, OREGON, AND IS TO BE RETURNED UPON REQUEST. IT SHALL NOT BE USED, DISCLOSED TO OTHERS OR COPIED IN WHOLE OR IN PART WITHOUT EXPRESS WRITTEN AUTHORIZATION BY ACTION EQUIPMENT COMPANY, INC. ALL RIGHTS OF DESIGN OR INVENTION ARE RESERVED.		ACTION EQUIPMENT COMPANY, INC.		TITLE					
TOTAL		TOTAL				PAN STROKE 22 mm		BALANCER STROKE 23 mm				P.O. BOX 3100 NEWBERG, OREGON 97132 PHONE (503) 537 - 1111 sales@actionconveyors.com www.actionconveyors.com		LINE 1 - 3 COLLECTION XHDB CONVEYOR FOR WINDFALL LUMBER					
↓		2,100 LBS 2,700 LBS ← 2,700 LBS 2,100 LBS		ONE (1) MODEL 42"/52" WIDE X 12" DEEP X 75'-0" LONG VIBRATING CONVEYOR		ECCENTRIC SHAFT RPM = 460								WINDFALL, AZ		B 9/12/2022 AS BUILT			
44,500 LBS WITHOUT MATERIAL				MATERIAL DESCRIPTION		THIRD ANGLE PROJECTION DRAWING TOLERANCES: UNLESS OTHERWISE SPECIFIED DECIMAL: X = ± .06" XX = ± 1/16" XXX = ± .005" FRACTION: XX = ± 1/16" X" = ± 1/2" ANGLE: OTHERWISE SPECIFIED DIMENSIONS: INCHES UNLESS OTHERWISE SPECIFIED		PAINT ORANGE (RAL # 2001) w/Safety Yellow Drive Guard		FOUNDATIONS, ANCHOR BOLTS, EMBEDDED STEEL FOR MOUNTING UNIT IN PLACE, SUPPORTS, MOTOR CONTROLS, CONDUIT AND ELECTRICAL WIRING, ALL NECESSARY CHUTEWORK, HOPPERS, SKIRTING AND ALL ITEMS NOT SHOWN INCLUDING UNLOADING AND ERECTION TO BE FURNISHED BY CUSTOMER UNLESS NOTED OTHERWISE.		SAFETY SAFETY HAS BEEN GIVEN CONSIDERATION IN THIS ARRANGEMENT. PLEASE REVIEW MAINTENANCE MANUAL PRIOR TO INSTALLATION.		ACTION VIBRATORY EQUIPMENT		A 6/2/2022 CHANGED RAL FLR PLA BY ACTION			
ACTION SUPPLIED EQUIPMENT ONLY		ACTION EQUIPMENT COMPANY, INC. ASSUMES NO RESPONSIBILITY FOR THE DESIGN OF CONVEYOR FOUNDATIONS AND / OR SUPPORTING STEEL		SAWDUST, CHIPS, TIM BLOCKS				SHIPPING BRACES MUST BE REMOVED BEFORE STARTING CONVEYOR. CUSTOMER TO SUPPLY STRUCTURAL SUPPORTS FOR MACHINE IF NOT PROVIDED BY ACTION.						DRAWN CBH 5/31/2022 SIZE D		REV. DATE REVISION		DWG NO. 2707-04-GA-01	

CUSTOMER APPROVAL AND DATE: