
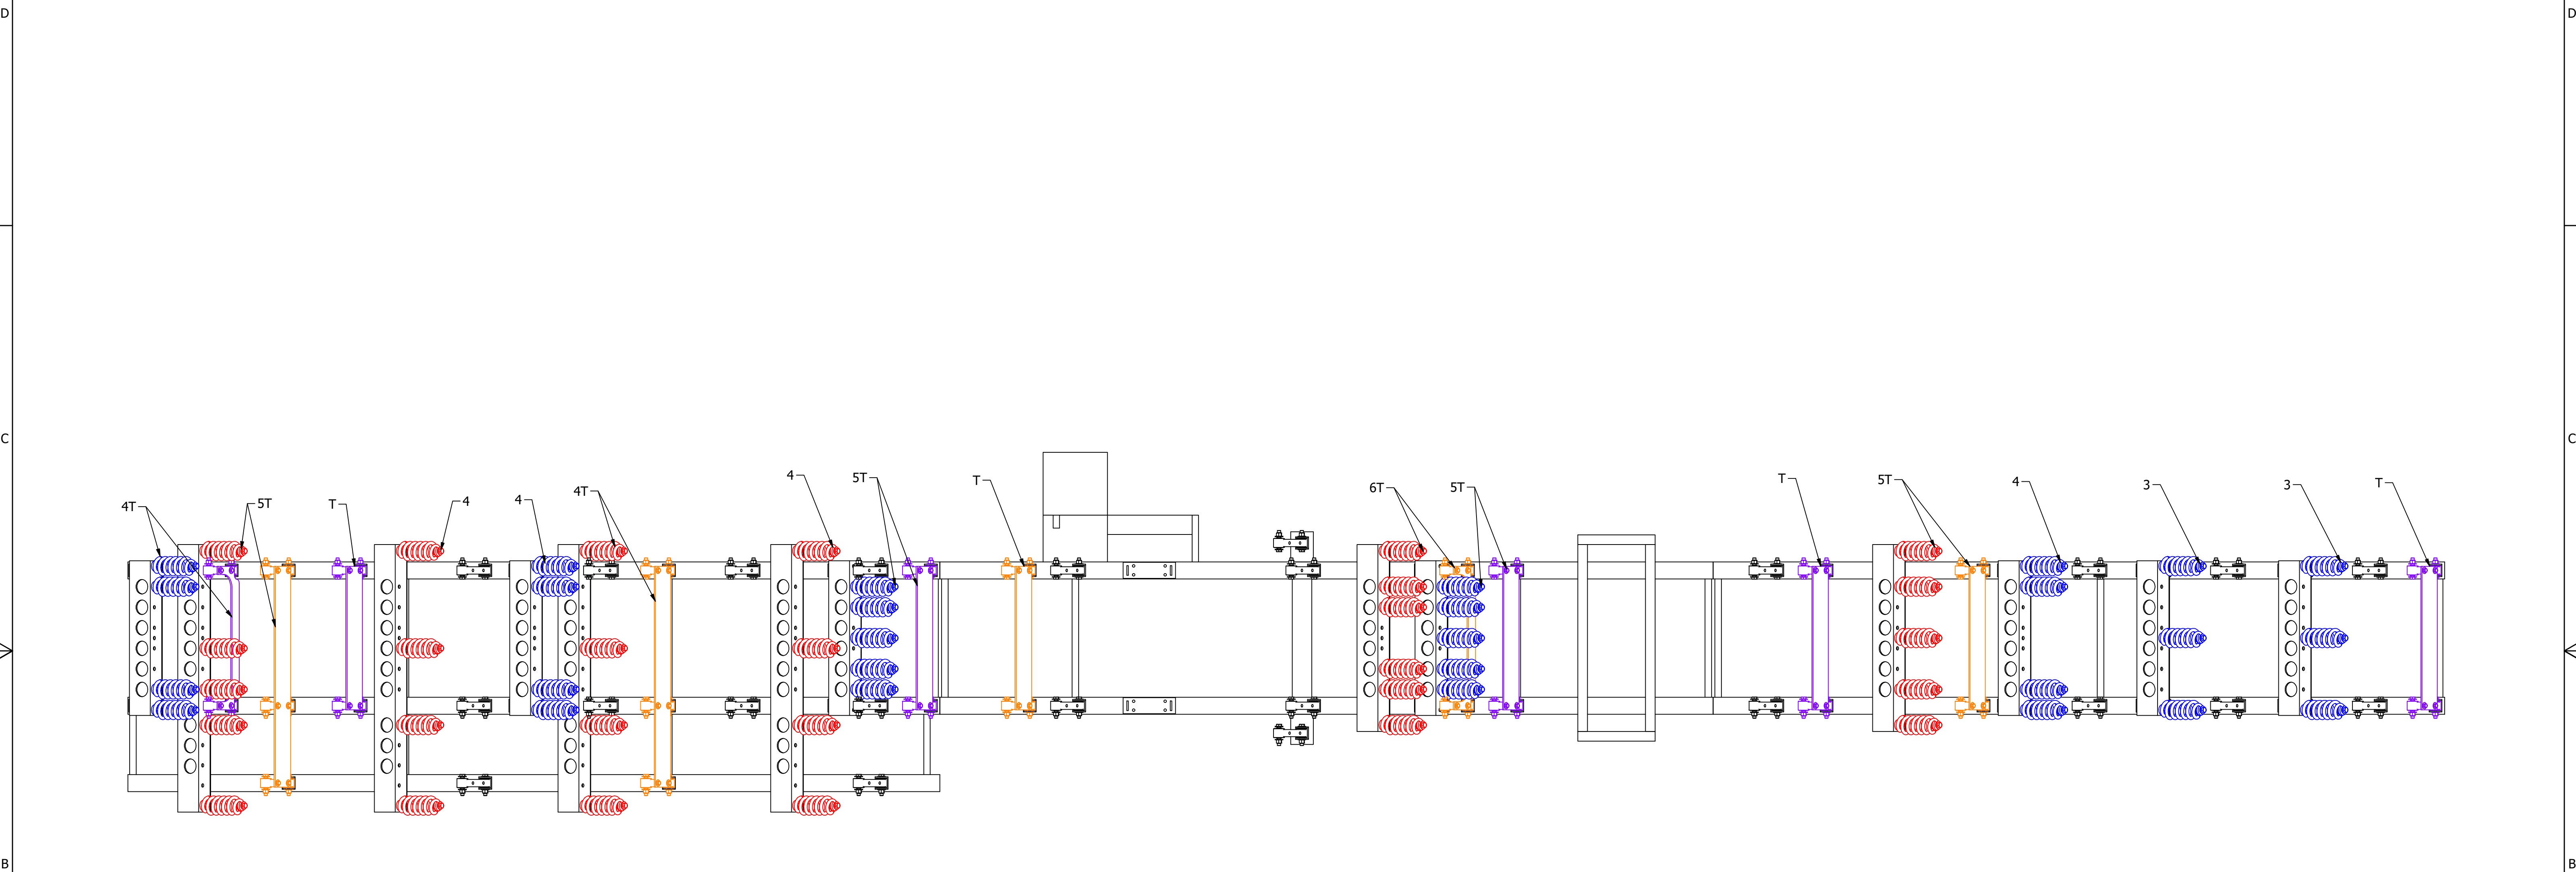
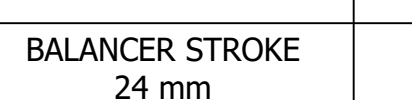


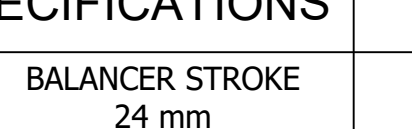

SPRING / TIEBAR DETAIL VIEW
SCALE 1 / 24

WM# SLPT-017-60-115										CUSTOMER APPROVAL AND DATE:													
STATIC LOAD TOTAL		DYNAMIC LOADING TOTAL		MODEL / SIZE		OPERATING SPECIFICATIONS		NOTES		THIS DRAWING WITH THE DESIGNS, IDEAS, AND DETAILS SHOWN HEREON IS THE PROPERTY OF ACTION EQUIPMENT COMPANY, INC., NEWBERG, OREGON, AND IS TO BE RETURNED UPON REQUEST. IT SHALL NOT BE USED, DISCLOSED TO OTHERS OR COPIED IN WHOLE OR IN PART WITHOUT EXPRESS WRITTEN AUTHORIZATION BY ACTION EQUIPMENT COMPANY, INC. ALL RIGHTS OF DESIGN OR INVENTION ARE RESERVED.		ACTION EQUIPMENT COMPANY, INC. P.O. BOX 3100 NEWBERG, OREGON 97132 PHONE (503) 537 - 1111 sales@actionconveyors.com www.actionconveyors.com		TITLE LINE 4 CHIPER INFEEED XHDB CONVEYOR FOR WINDFALL LUMBER WINDFALL, AZ									
 28,585 LBS WITHOUT MATERIAL ACTION SUPPLIED EQUIPMENT ONLY		 1,700 LBS		ONE (1) MODEL 42"/52" WIDE X 12" DEEP X 66'-4" LONG VIBRATING CONVEYOR		PAN STROKE 23 mm BALANCER STROKE 24 mm		PAINT ORANGE (RAL # 2001) w/Safety Yellow Drive Guard		FOUNDATIONS, ANCHOR BOLTS, EMBEDDED STEEL FOR MOUNTING UNIT IN PLACE, SUPPORTS, MOTOR CONTROLS, CONDUIT AND ELECTRICAL WIRING, ALL NECESSARY CHUTEWORK, HOPPERS, SKIRTING AND ALL ITEMS NOT SHOWN INCLUDING UNLOADING AND ERECTION TO BE FURNISHED BY CUSTOMER UNLESS NOTED OTHERWISE.		SAFETY SAFETY HAS BEEN GIVEN CONSIDERATION IN THIS ARRANGEMENT. PLEASE REVIEW MAINTENANCE MANUAL PRIOR TO INSTALLATION.				B		9/22/2022		AS BUILT			
				ECCENTRIC SHAFT RPM = 455		MATERIAL DESCRIPTION										THIRD ANGLE PROJECTION DRAWING TOLERANCES: UNLESS OTHERWISE SPECIFIED DECIMAL: X = ± .06" FRACTION: X/X = ± 1/16" ANGLE: XXX = ± .010" XXX = ± .005" DIMENSIONS: INCHES UNLESS OTHERWISE SPECIFIED		A		6/2/2022		CHANGED RAL, FLR PLA BY ACTION	
		ACTION EQUIPMENT COMPANY, INC. ASSUMES NO RESPONSIBILITY FOR THE DESIGN OF CONVEYOR FOUNDATIONS AND / OR SUPPORTING STEEL.		SAWDUST, CHIPS, TIM BLOCKS				SHIPPING BRACES MUST BE REMOVED BEFORE STARTING CONVEYOR. CUSTOMER TO SUPPLY STRUCTURAL SUPPORTS FOR MACHINE IF NOT PROVIDED BY ACTION.						DRAWN CBH		5/17/2022		SIZE D		REV. DATE		REVISION	
																APPROVED				DWG NO.		2707-06-GA-01	
8		1		7		2		6		3		4		5		6		7		8		9	
																						SHEET 3 OF 4	