

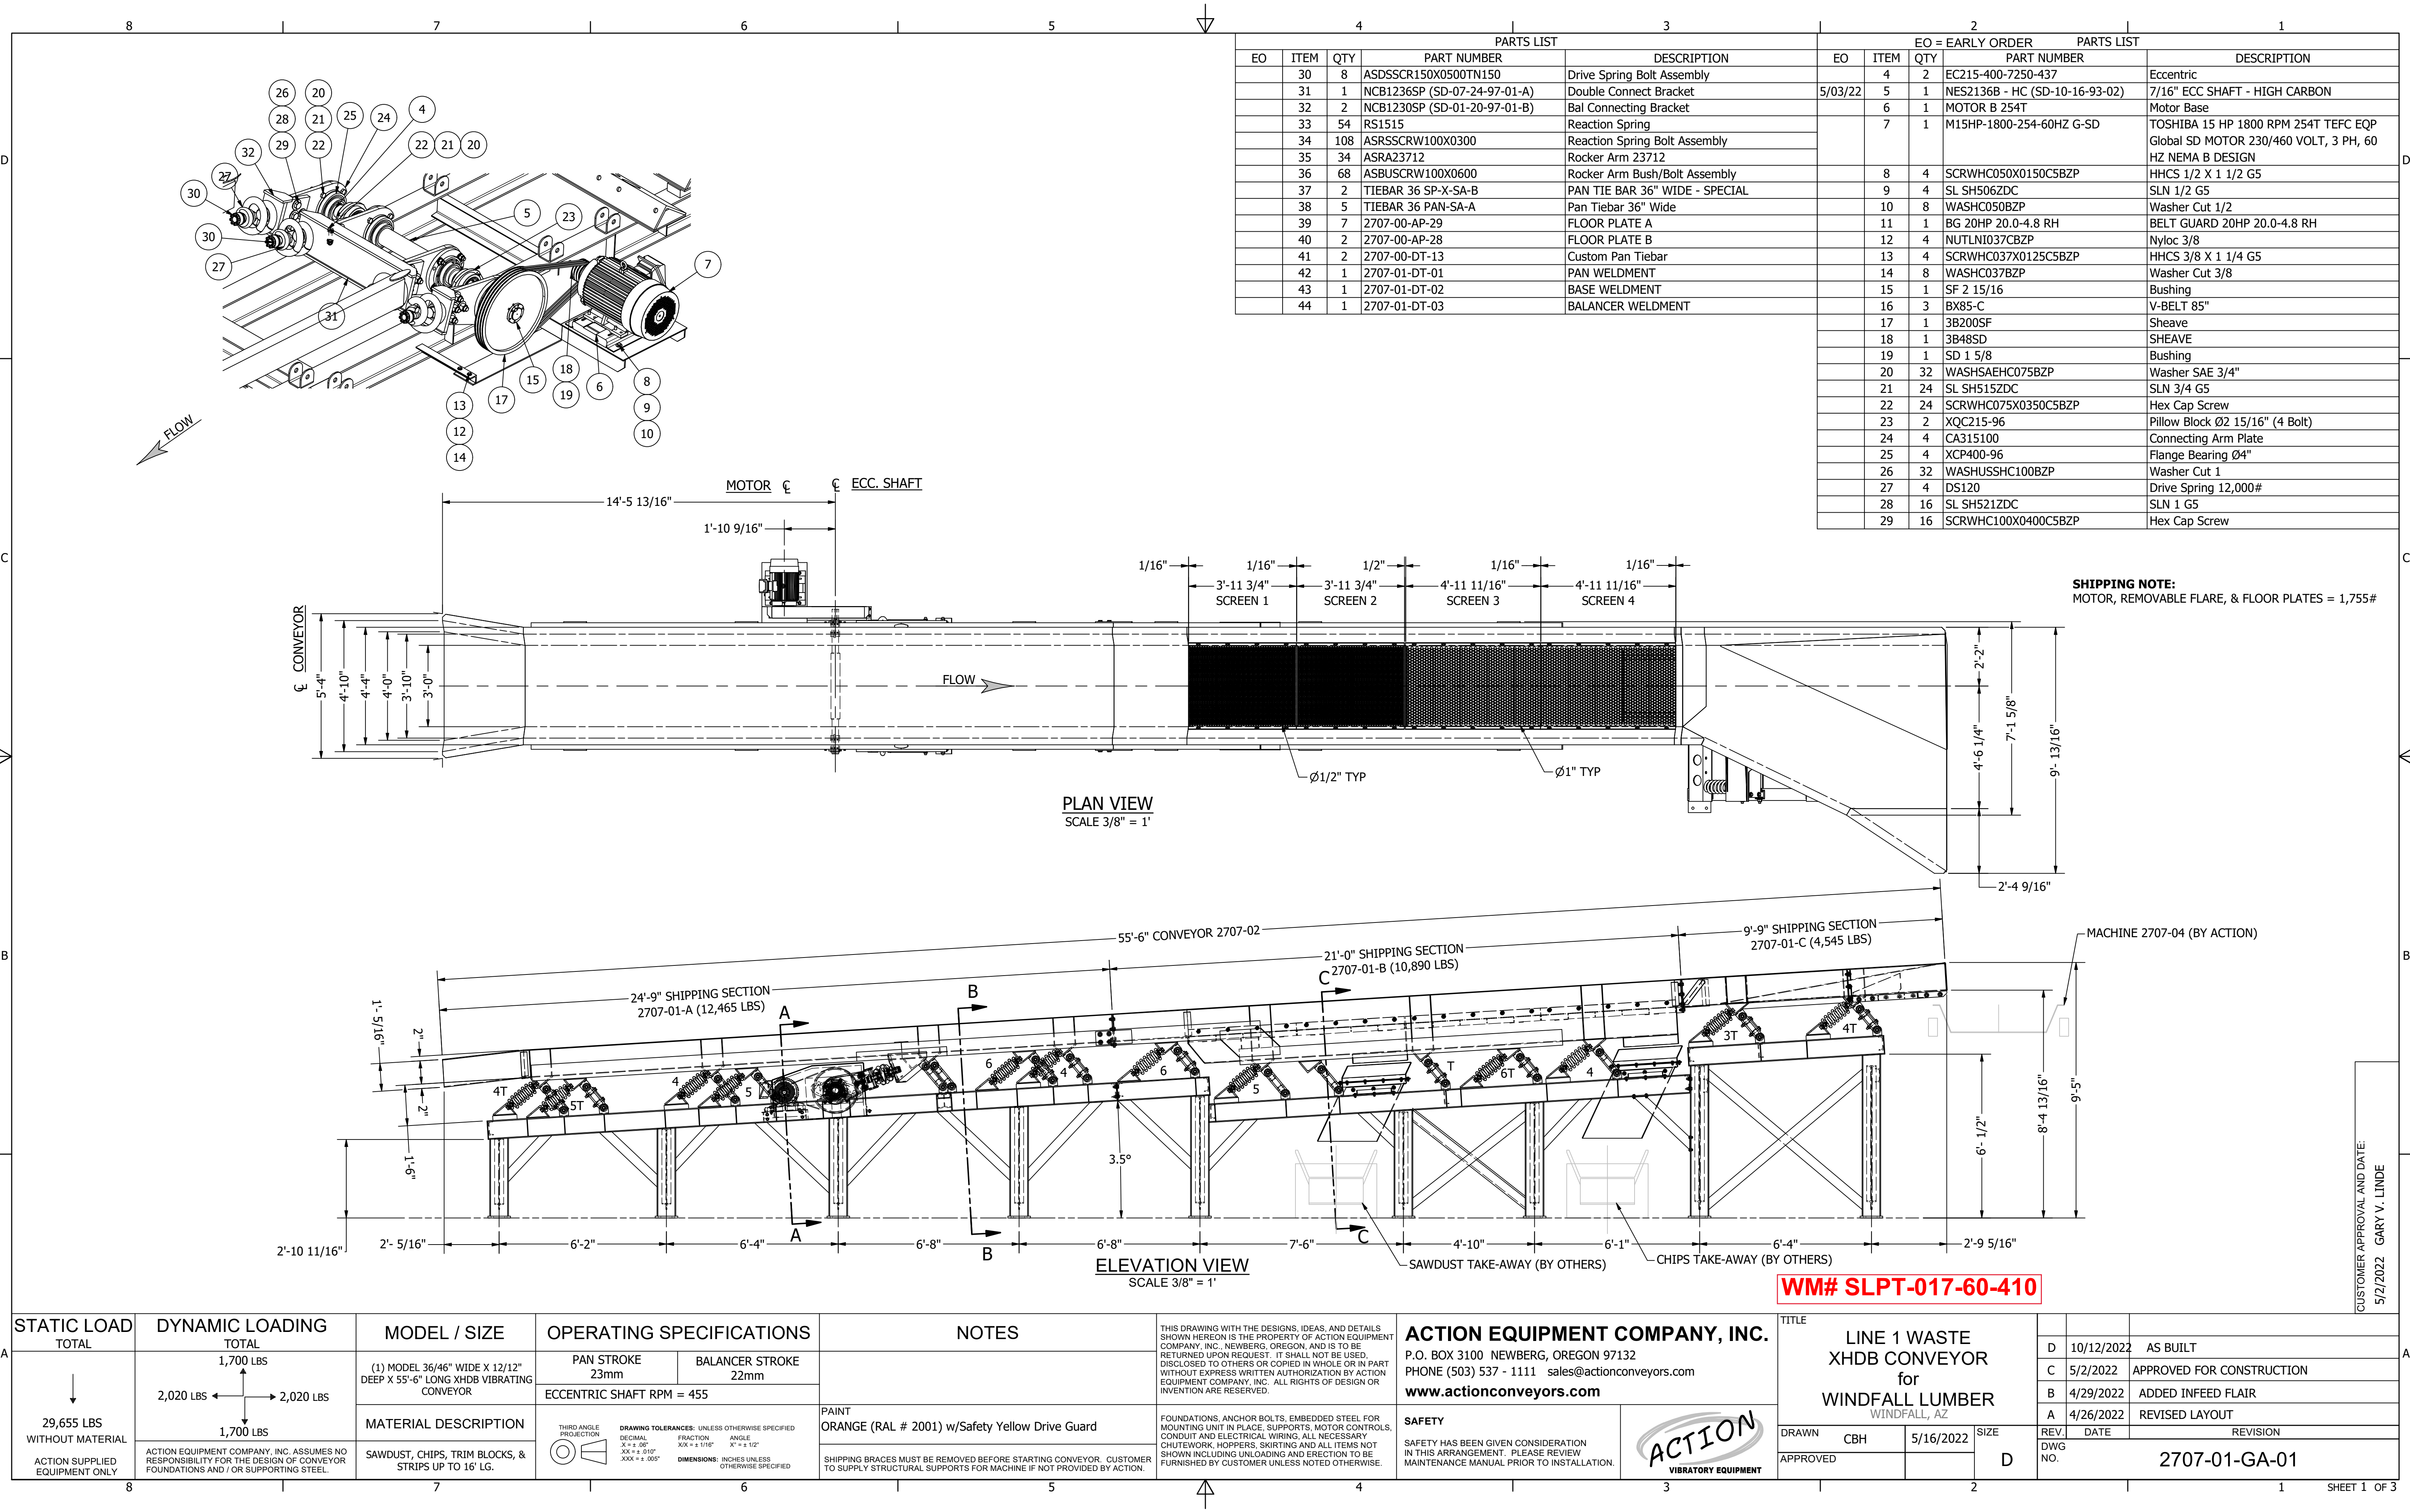


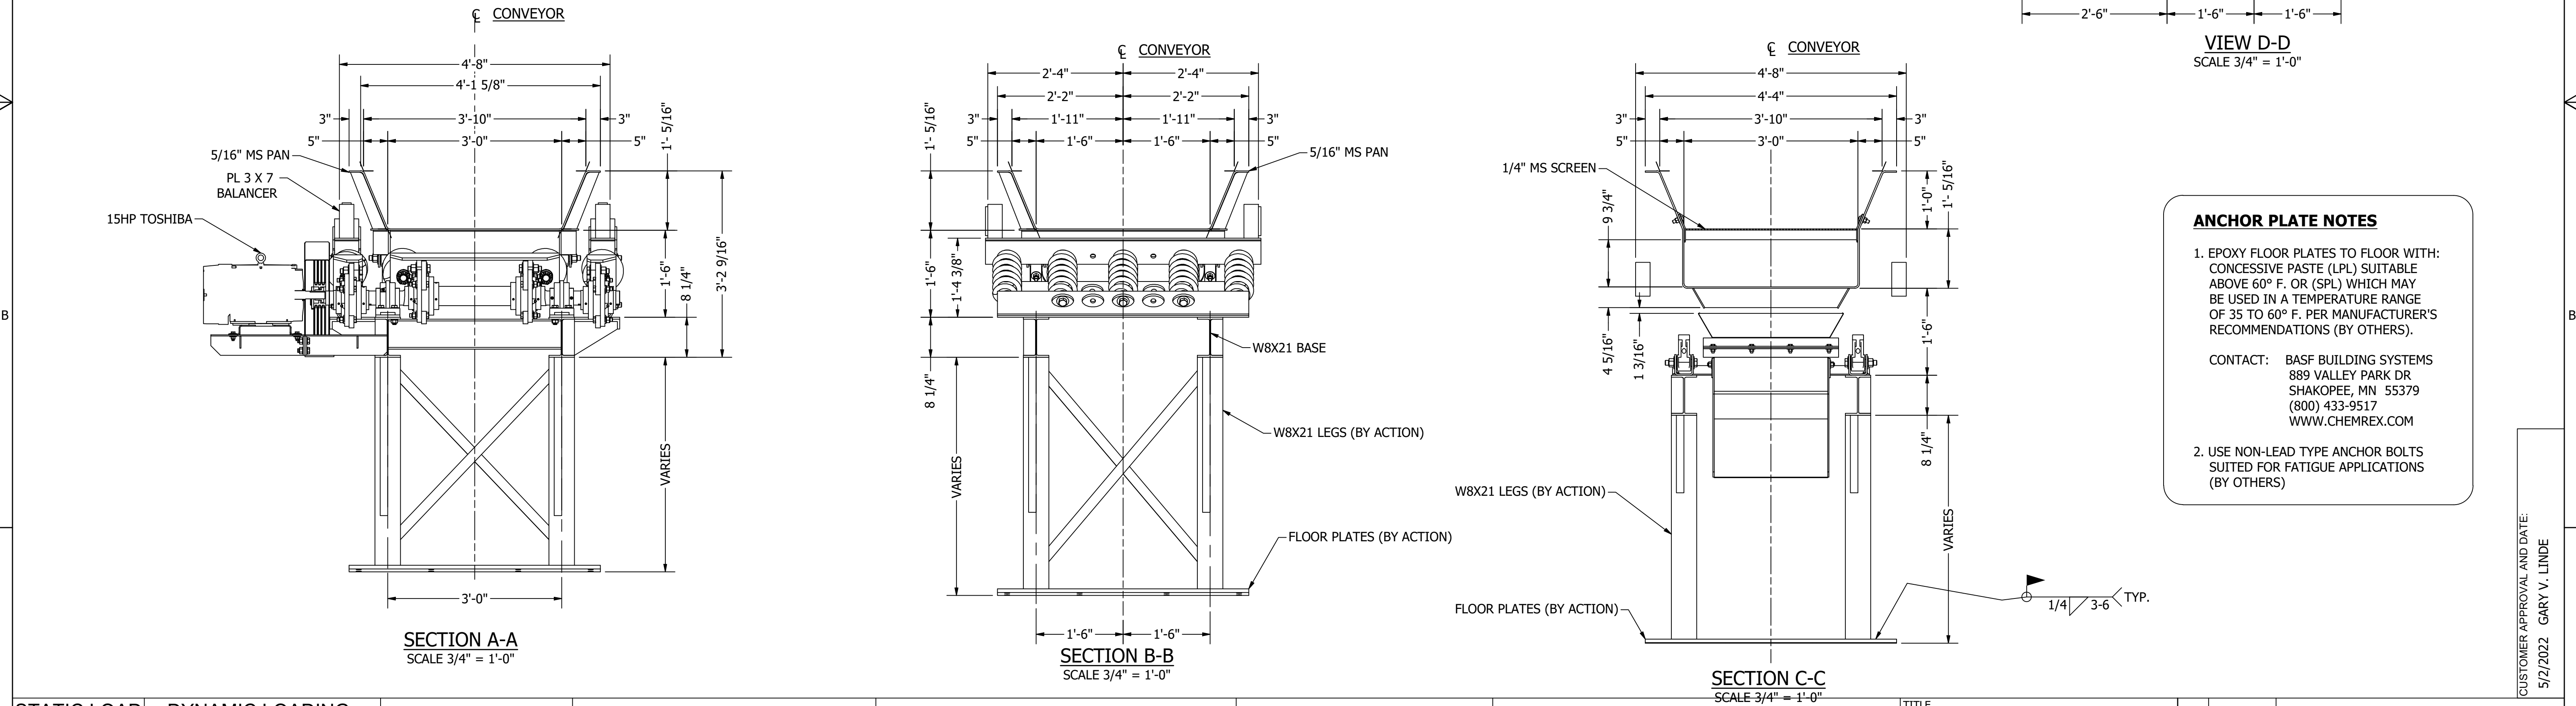

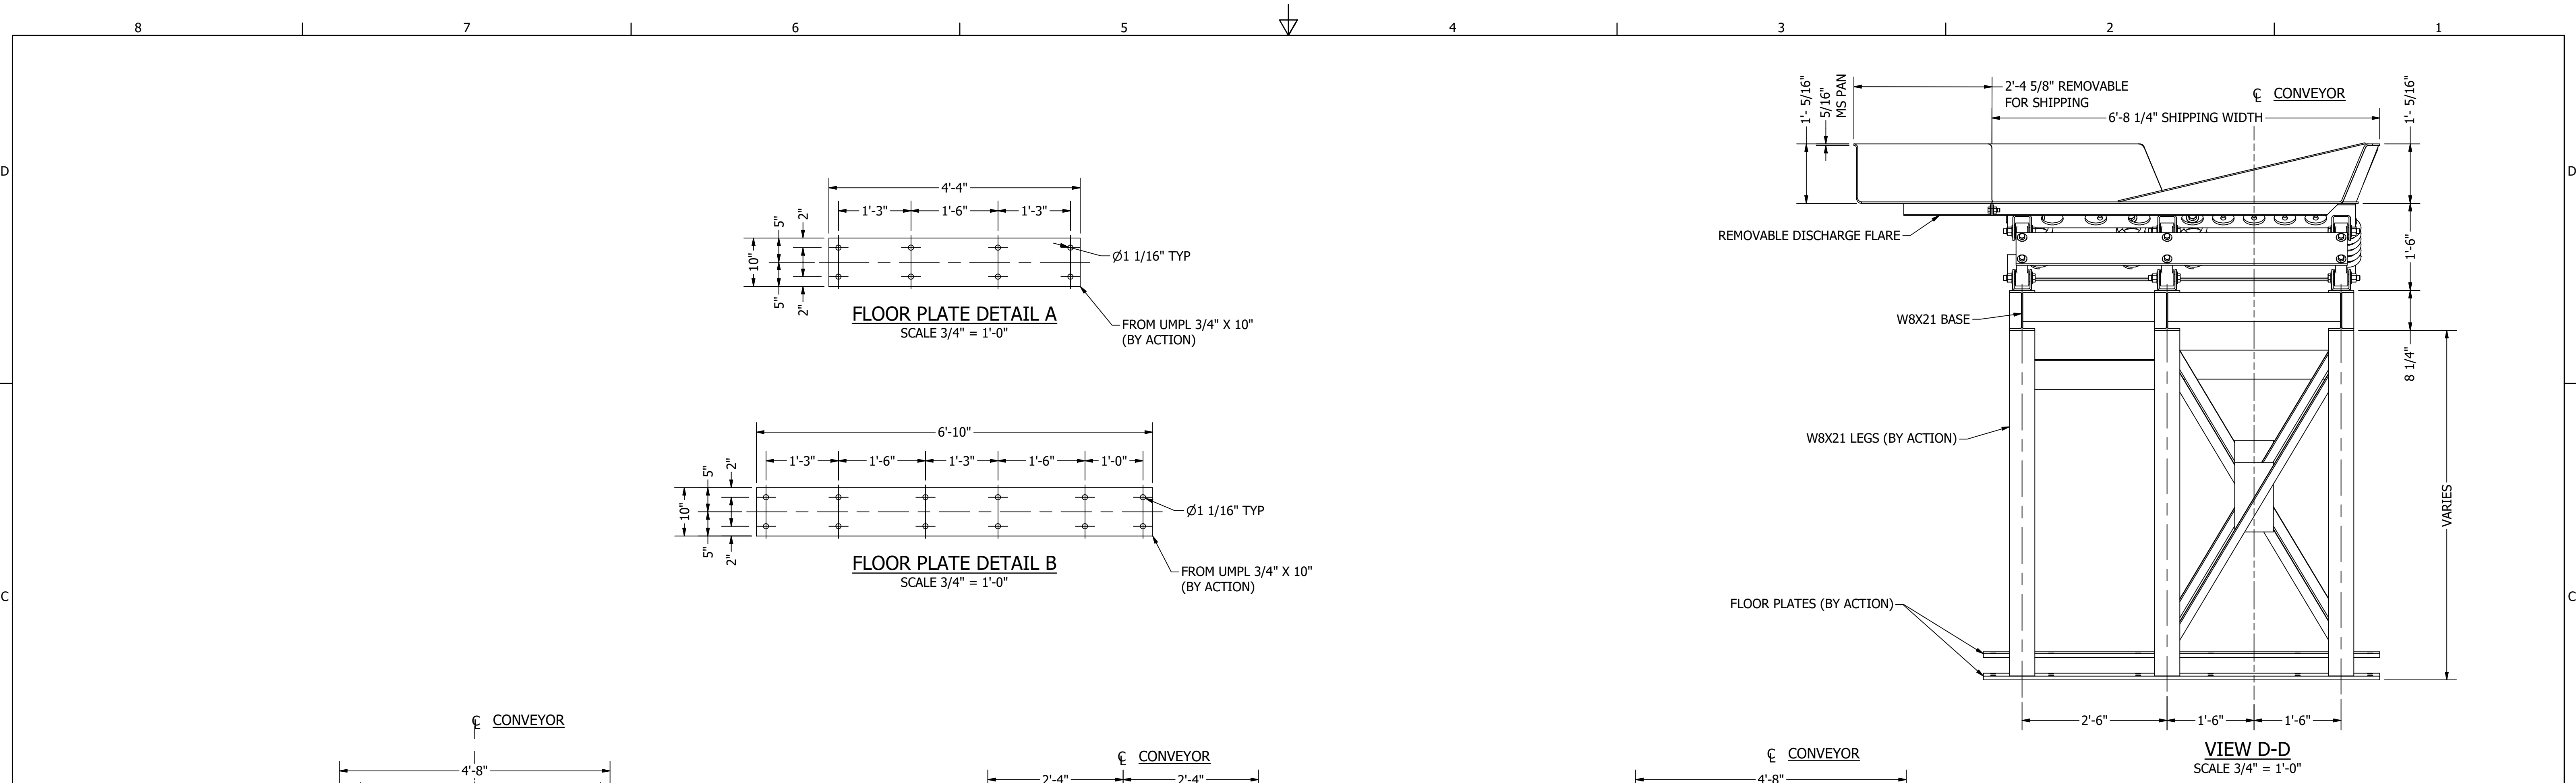

ANCHOR PLATE NOTES

1. EPOXY FLOOR PLATES TO FLOOR WITH:
CONCESSIVE PASTE (LPL) SUITABLE
ABOVE 60° F. OR (SPL) WHICH MAY
BE USED IN A TEMPERATURE RANGE
OF 35 TO 60° F. PER MANUFACTURER'S
RECOMMENDATIONS (BY OTHERS).

CONTACT: BASF BUILDING SYSTEMS
889 VALLEY PARK DR
SHAKOPEE, MN 55379
(800) 433-9517
WWW.CHEMREX.COM

2. USE NON-LEAD TYPE ANCHOR BOLTS
SUITED FOR FATIGUE APPLICATIONS
(BY OTHERS)

STATIC LOAD		DYNAMIC LOADING		MODEL / SIZE		OPERATING SPECIFICATIONS		NOTES		THIS DRAWING WITH THE DESIGNS, IDEAS, AND DETAILS SHOWN HEREON IS THE PROPERTY OF ACTION EQUIPMENT COMPANY, INC., NEWBERG, OREGON, AND IS TO BE RETURNED UPON REQUEST. IT SHALL NOT BE USED, DISCLOSED TO OTHERS OR COPIED IN WHOLE OR IN PART WITHOUT EXPRESS WRITTEN AUTHORIZATION BY ACTION EQUIPMENT COMPANY, INC. ALL RIGHTS OF DESIGN OR INVENTION ARE RESERVED.		ACTION EQUIPMENT COMPANY, INC. P.O. BOX 3100 NEWBERG, OREGON 97132 PHONE (503) 537 - 1111 sales@actionconveyors.com www.actionconveyors.com		TITLE		LINE 1 WASTE XHDB CONVEYOR for WINDFALL LUMBER WINDFALL, AZ		D		10/12/2022		AS BUILT			
TOTAL		TOTAL		(1) MODEL 36/46" WIDE X 12/12" DEEP X 55'-6" LONG XHDB VIBRATING CONVEYOR		PAN STROKE 23mm BALANCER STROKE 22mm ECCENTRIC SHAFT RPM = 455		PAINT ORANGE (RAL # 2001) w/Safety Yellow Drive Guard		FOUNDATIONS, ANCHOR BOLTS, EMBEDDED STEEL FOR MOUNTING UNIT IN PLACE, SUPPORTS, MOTOR CONTROLS, CONDUIT AND ELECTRICAL WIRING, ALL NECESSARY CHUTEWORK, HOPPERS, SKIRTING AND ALL ITEMS NOT SHOWN INCLUDING UNLOADING AND ERECTION TO BE FURNISHED BY CUSTOMER UNLESS NOTED OTHERWISE.		SAFETY SAFETY HAS BEEN GIVEN CONSIDERATION IN THIS ARRANGEMENT. PLEASE REVIEW MAINTENANCE MANUAL PRIOR TO INSTALLATION.		DRAWN CBH		5/16/2022		SIZE		REV.		DATE		REVISION	
29,655 LBS WITHOUT MATERIAL		1,700 LBS 2,020 LBS 2,020 LBS		MATERIAL DESCRIPTION		THIRD ANGLE PROJECTION DRAWING TOLERANCES: UNLESS OTHERWISE SPECIFIED DECIMAL: .X = ± .06" FRACTION: XX/XX = ± 1/16" ANGLE: X° = ± 1/2" DIMENSIONS: INCHES UNLESS OTHERWISE SPECIFIED		SHIPPING BRACES MUST BE REMOVED BEFORE STARTING CONVEYOR. CUSTOMER TO SUPPLY STRUCTURAL SUPPORTS FOR MACHINE IF NOT PROVIDED BY ACTION.				ACTION VIBRATORY EQUIPMENT		APPROVED				D		DWG NO.		2707-01-GA-01			
8		1		7		6		5		4		3		2		1		SHEET 2 OF 3							

CUSTOMER APPROVAL AND DATE:
5/2/2022 GARY V. LINDE

